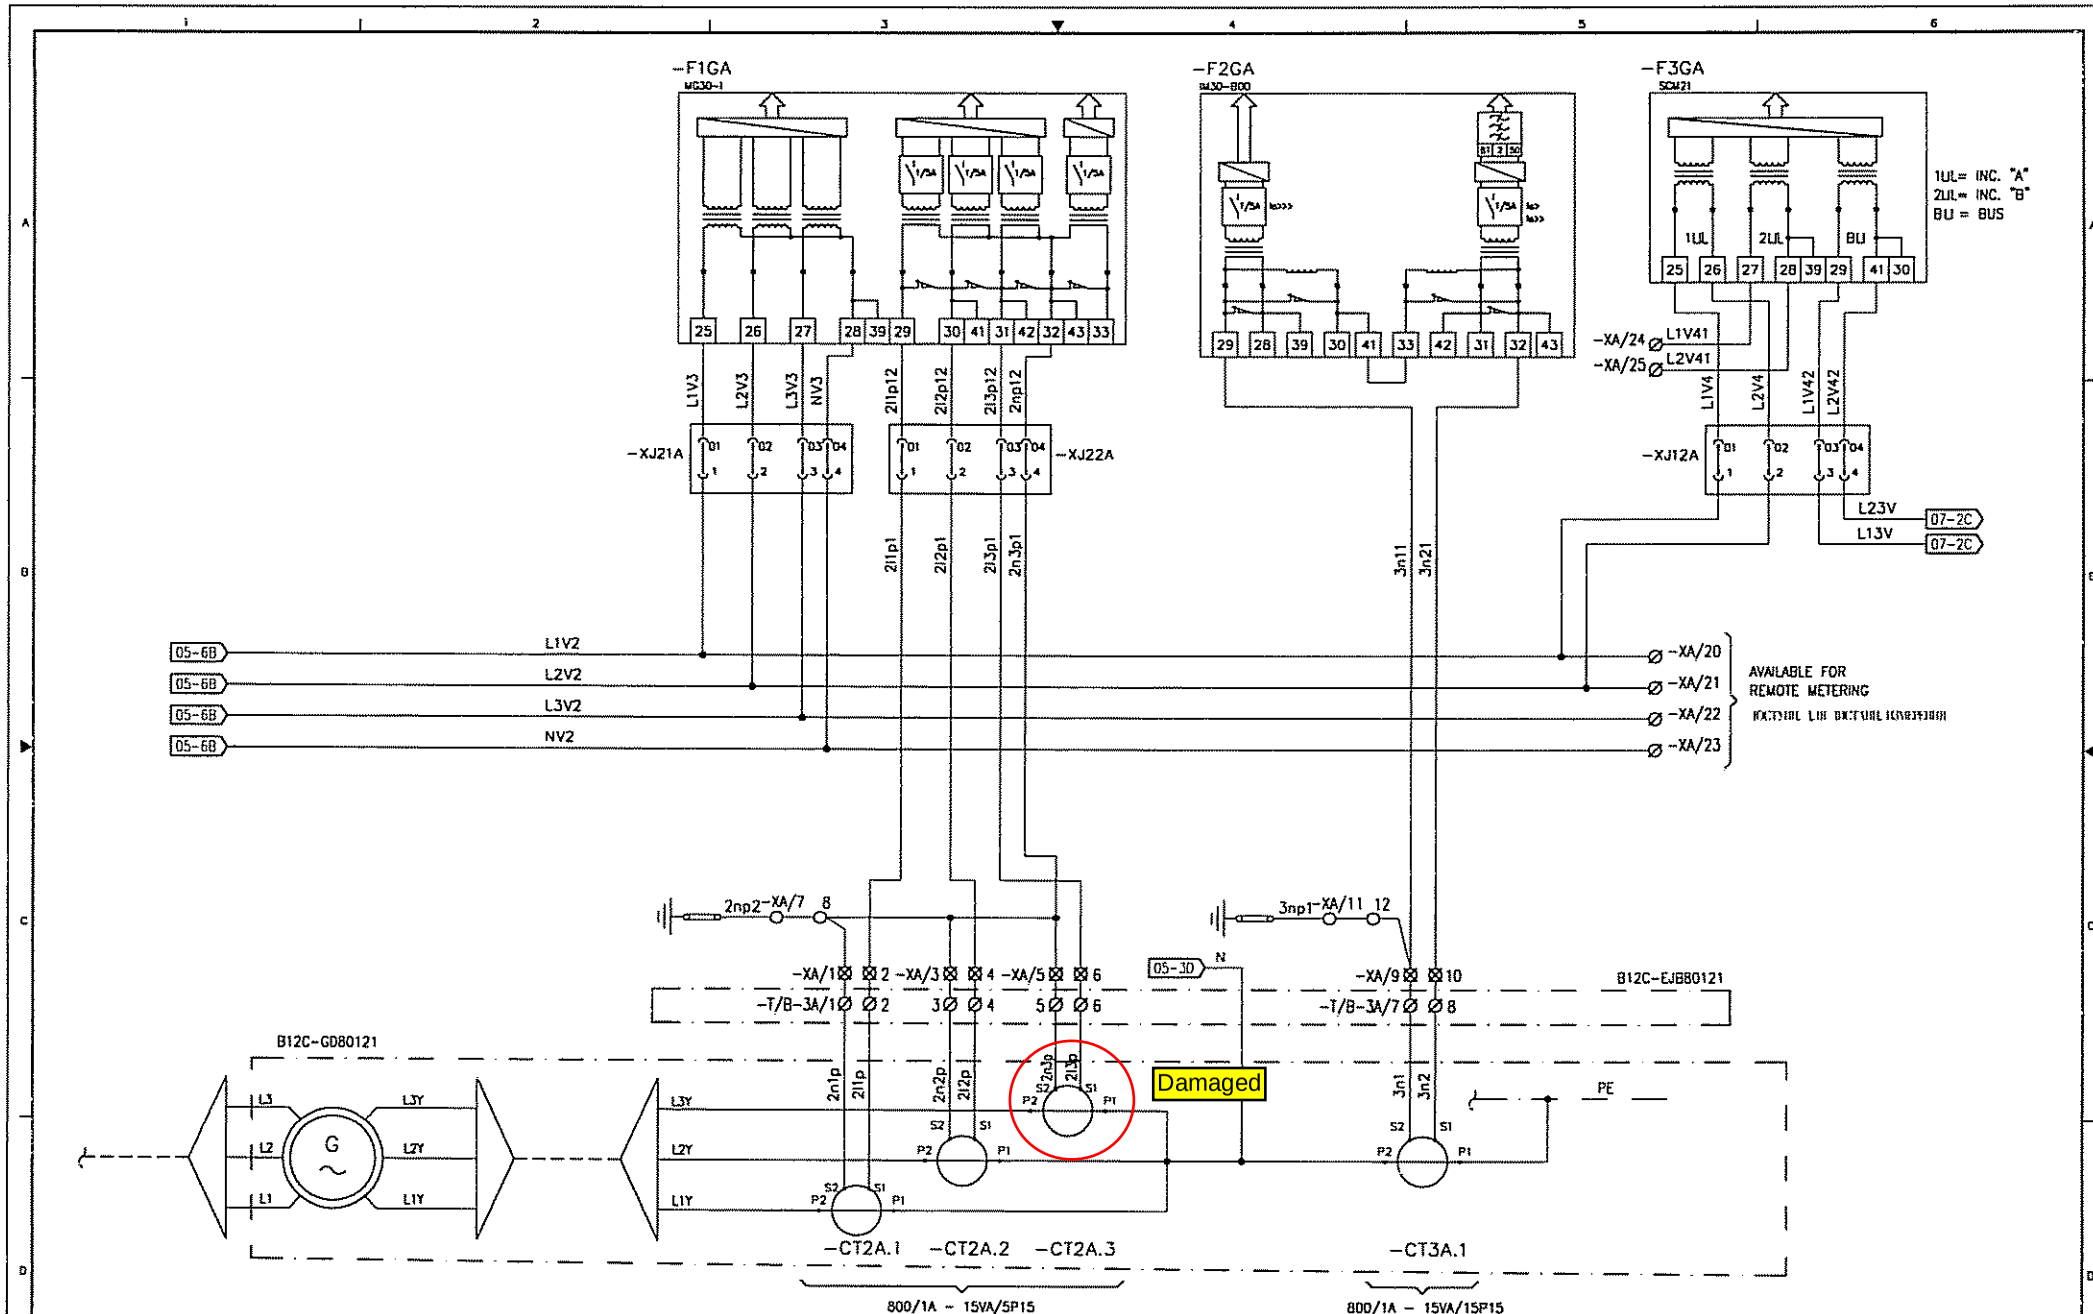

Drawn/	S.T.
Checked/	R.S
Dwg/	209SK187
Job/	2157/1

Skema SKEMA SPA QUADRI ELETTRICI

©All right reserved

DOCUMENT DESCRIPTION / НАИМЕНОВАНИЕ ДОКУМЕНТА
SCHEMATIC DIAGRAM

SHEET DESCRIPTION / НАИМЕНОВАНИЕ ЛИСТА
SCHEMATIC DIAGRAM GENERATOR INCOMER "A"

XXXX

REV	DATE	DESCRIPTION	DRWN	CHK'D	APP'D	BTC
04	19.04.04	AS BUILT	S.T.	R.S.		
03	16.01.04	REVISED AS YOUR COMMENTS 14.01.04	S.T.	R.S.		
02	07.01.04	REVISED AS YOUR COMMENTS 03.01.04	S.T.	R.S.		
01	27.11.03	REVISED AS YOUR COMMENTS 25.11.03	S.T.	R.S.		
00	05.09.03	ISSUED FOR APPROVAL	S.T.	R.S.		

CLIENT : btc
EPC CONT. : Petrofac International Ltd
AGT PIPELINES PROJECT
BTC CONT. NO: C-02-BTC-45196 | CONTRACTOR JOB NO :
SCALE : 1:20 | ORIGINAL DRG. SIZE : A3

SCHEMATIC DIAGRAM FOR
GENERATOR INCOMER "A" 400V SWITCHBOARD
IP STATION IPA1

LIFE CYCLE CODE:	LIFE CYCLE DESCRIPTION:	CLASS:	LANG. CODE
D	OPERATIONAL THROUGH LIFE	I	D

DRAWING NUMBER : BTC0002-E120-EU-PEA-00001-005-00006
SHEET NO. 006 | REV 04
FILE NO. -